

DO NOT SCALE WORK TO FIGURED DIMENSIONS ONLY
ALL EXISTING DIMENSIONS TO BE CHECKED ON SITE
DRAWN ON AUTOCAD R14 AT STRIDE TREGLOWN GROUP PLC
XREF SCALE...
LAYERS ON THIS DRAWING COMPLY WITH BS 1192: PART 5

Note:

Information taken from record
drawings - not subject to survey

**FIRE ALARM CALL POINT**

**FIRE ALARM BELL / SOUNDER**

**FIRE ALARM DETECTOR**

**FIRE ALARM DETECTOR / SOUNDER**

**EMERGENCY LIGHT**

**DISTRIBUTION BOARDS**


**ELECTRICAL METER**

**SWITCHED FUSE**

**E(NM)**

**DB**

**M**

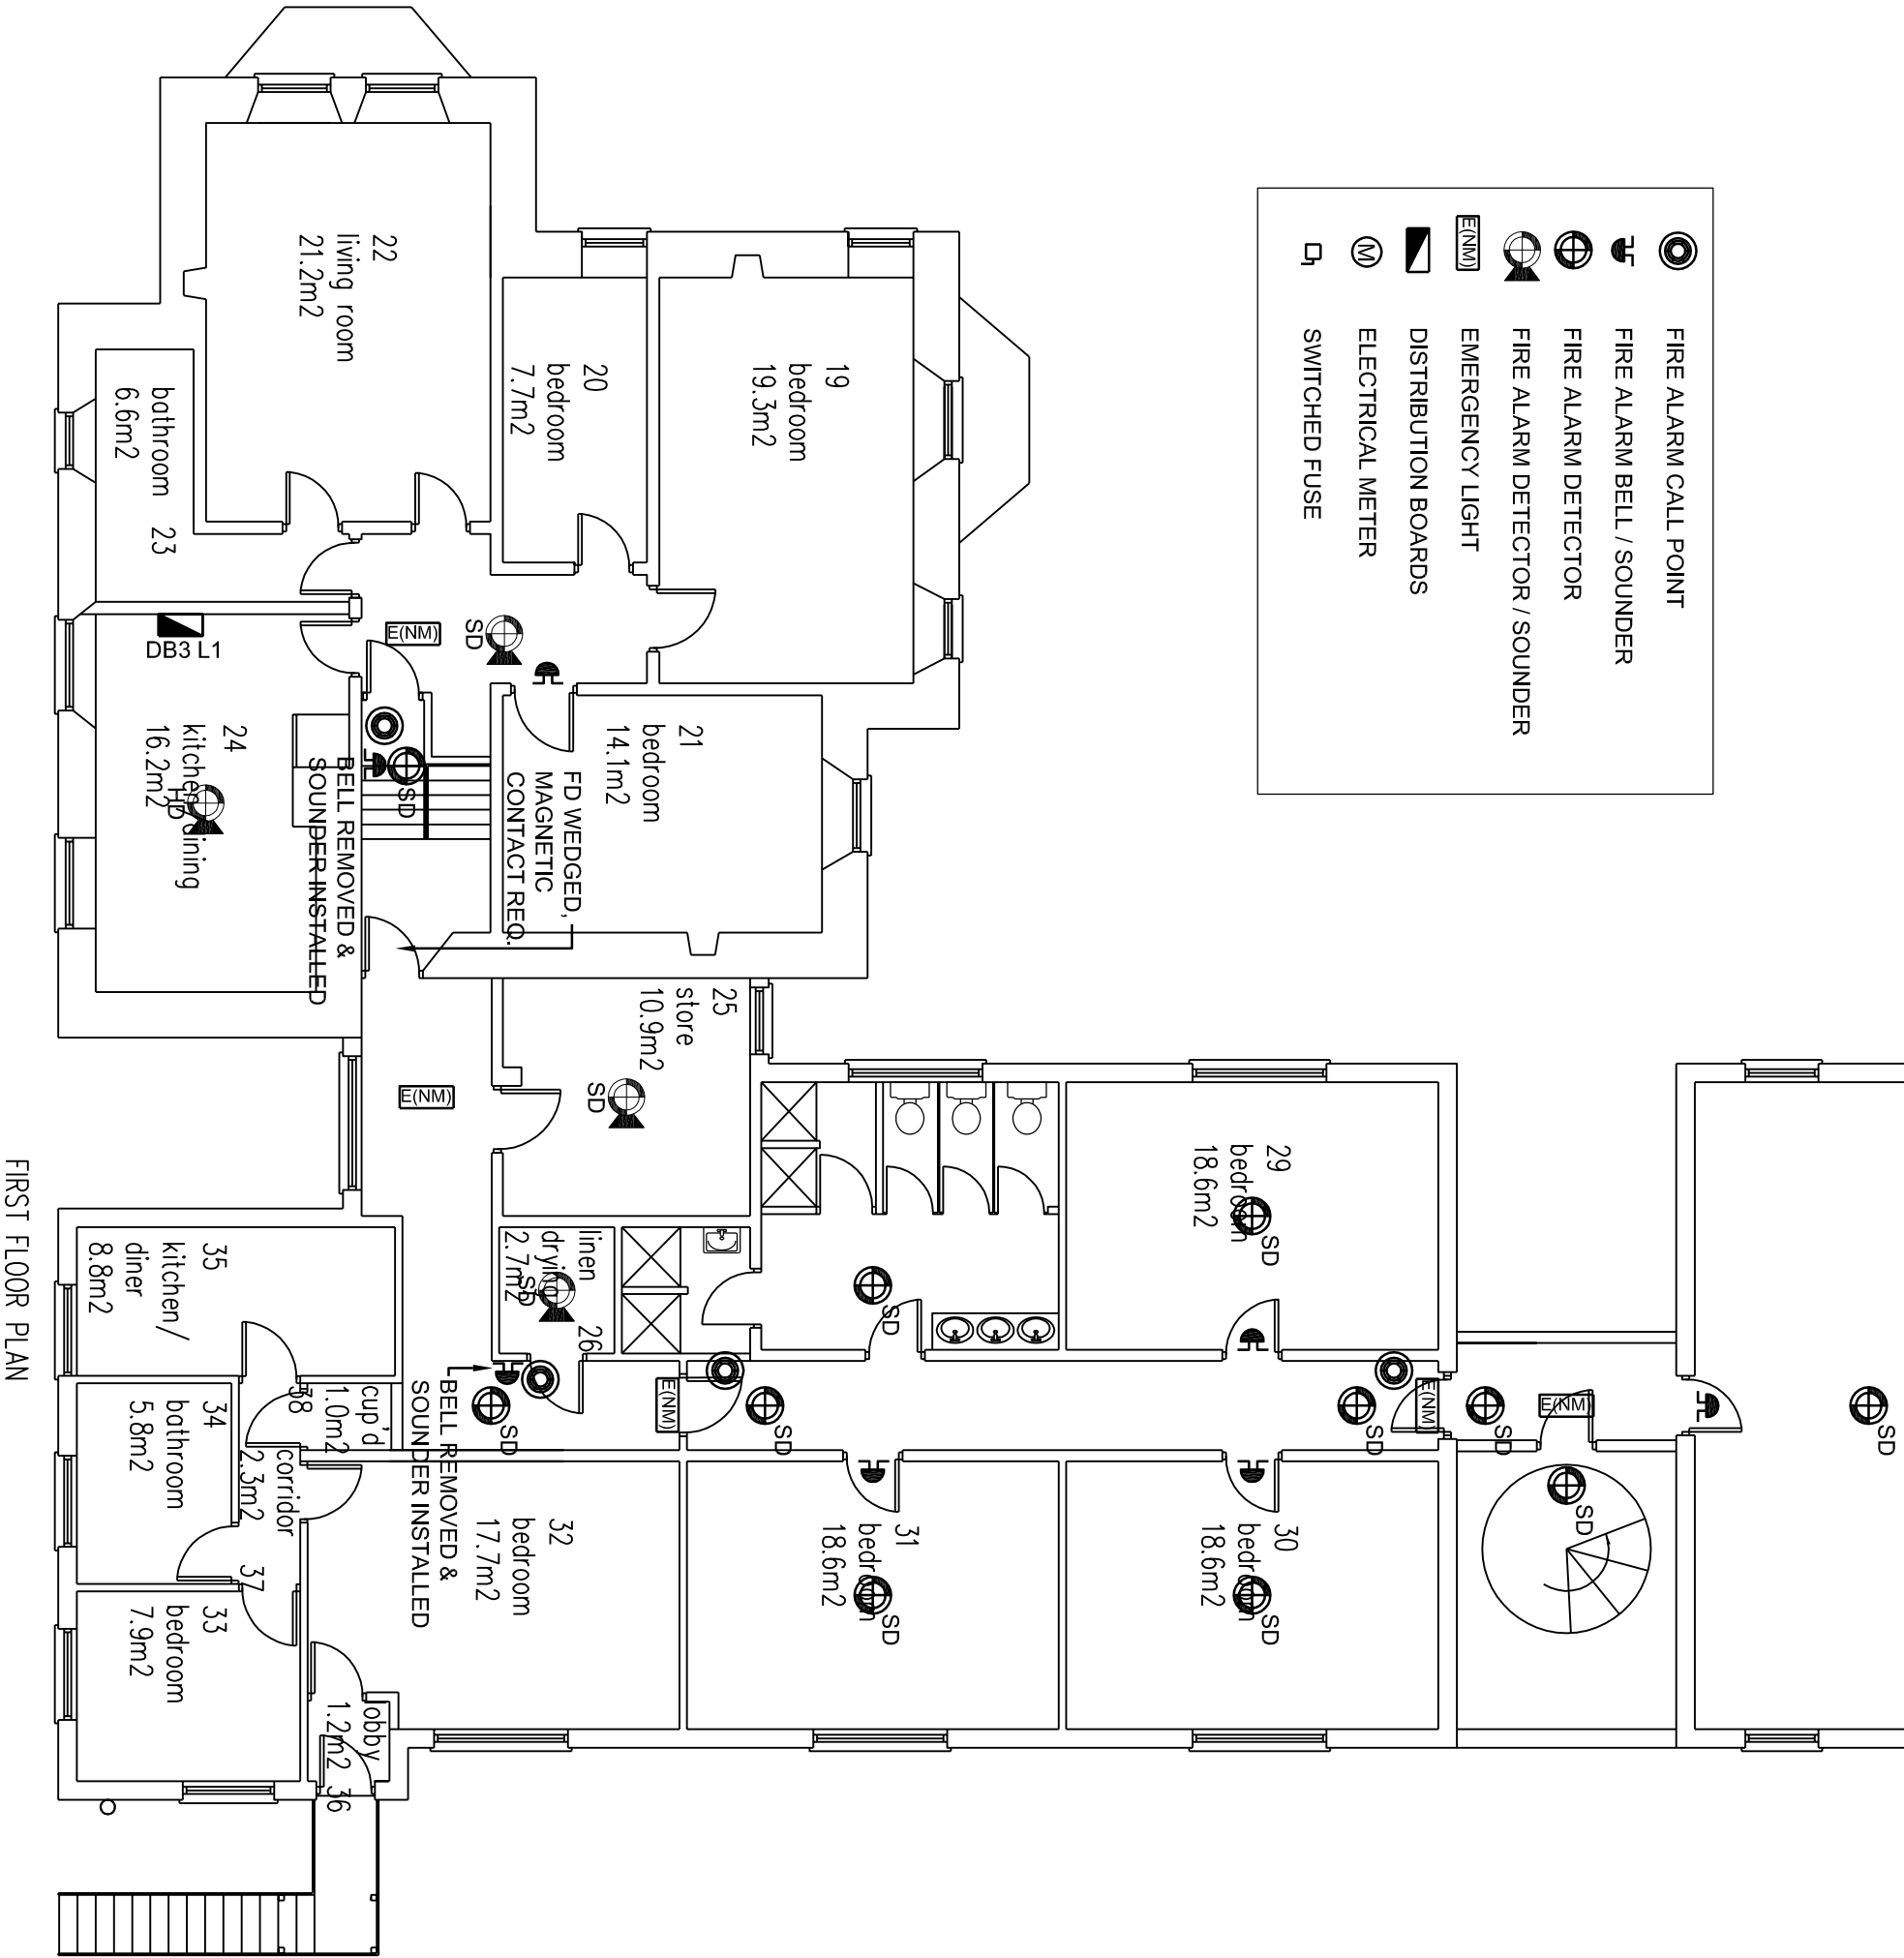

PP		DTX		Record Drawing	
date	rev	name	chk	note	



STRIDE TREGLOWN

Architecture Town Planning Interior Design Building Surveying Graphic Design
11 The Crescent, Plymouth, PL1 3AB
Tel: (01752) 202088 Fax: (01752) 202089

PROJECT
**ISLES OF SCILLY
ASSET MANAGEMENT PLAN**

DRAWING TITLE
**MUNDSLEY HOSTEL
GROUND FLOOR PLAN
FIRE ALARM & EMERG. LIGHT LAYOUTS**

SCALE	DATE	DRAWN BY	CHECKED BY
1:100	02/02/12		

DRAWING NUMBER	REV/ISON	DRAWN ON
020212/M/02	-	ACAD 2000