


Ordnance Survey, (c) Crown Copyright 2015. All rights reserved. Licence number 100022432

Location Plan 1 to 1250

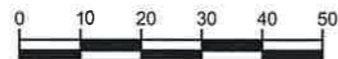

RTP
CHARTERED BUILDING SURVEYORS

RTP Surveyors
 12 Arwenack Street
 Falmouth, Cornwall, TR11 3JD

T 01326 318599
 F 01326 318179
 E Falmouth@rtpsurveyors.co.uk
 www.rtpsurveyors.co.uk

Office also at BodmIn



PROJECT
**Historic Building Survey
 Wellcross, Hugh Town
 Isles of Scilly**

CLIENT
 Cornwall Rural Housing Association

DRAWING TITLE
Location Plan

SCALE
1 : 1250
 DATE
 03/02/15


DRAWN BY
 TH
 CHECKED BY

DRAWING NO.
10612-01

REV. SIZE
A4

This drawing is copyright. All materials and workmanship to comply with the current British Standards and codes of practice. Contractors to check ALL dimensions. Work from figured dimensions ONLY. Report ANY discrepancy to Architect or Surveyor before proceeding. IF IN ANY DOUBT ASK.

REVISION	AMENDMENT	INITIAL	DATE

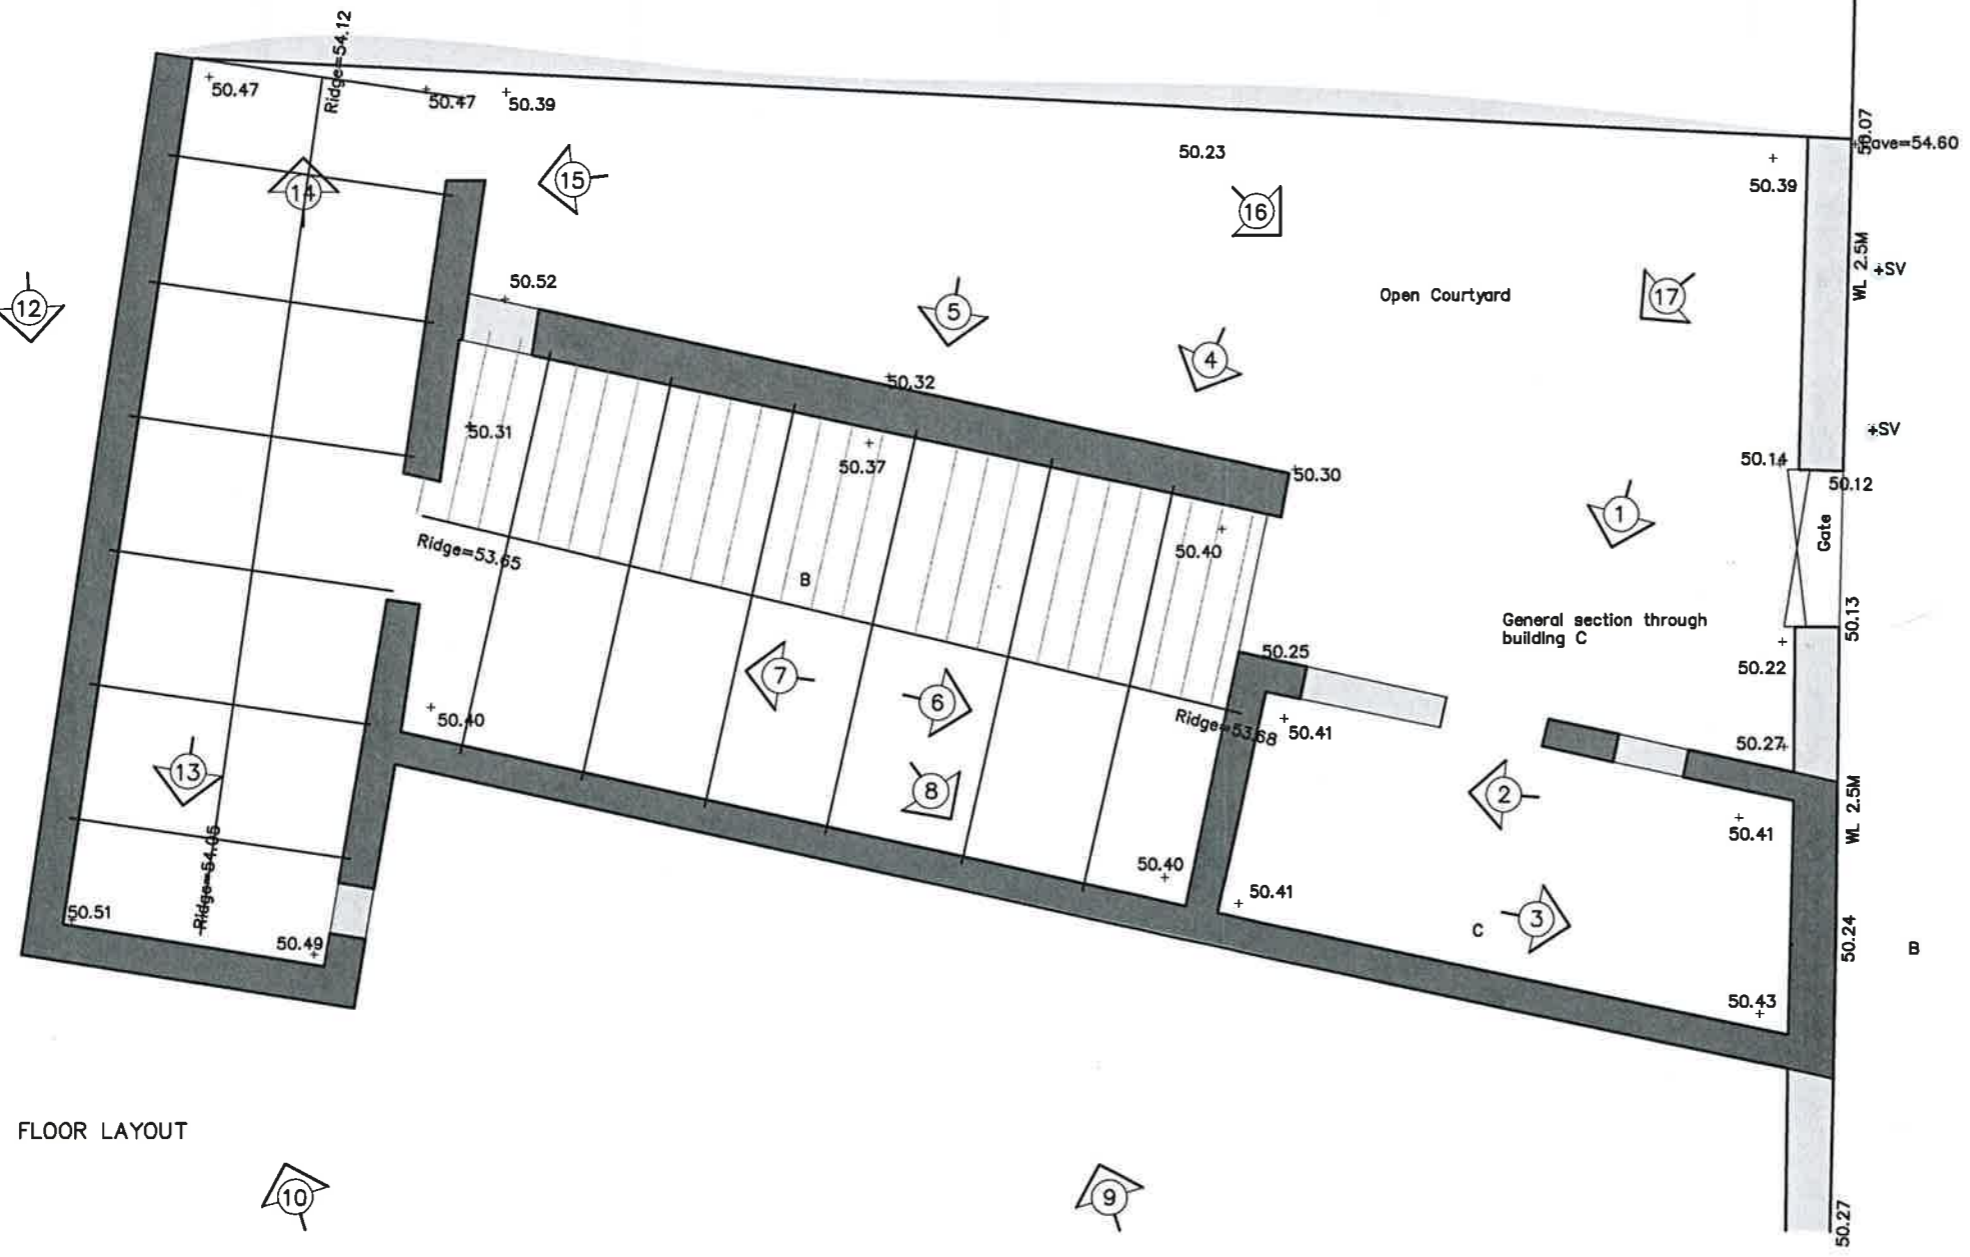

FLOOR LAYOUT

GENERAL NOTES

49.79
KB
49.91
49.97
Well Cross
50.08
50.11
18
50.22

REVISION	AMENDMENT	INITIAL	DATE

- STATUS
- Preliminary
 - Planning
 - Building Regulations
 - Tender
 - Contract
 - As Built

PROJECT
Historic Building Survey
Record Plan
Wellcross, Hugh Town
Isles of Scilly

CLIENT
Cornwall Rural Housing
Association

DRAWING TITLE
Plan Survey
Photograph Key

RTP
CHARTERED BUILDING SURVEYORS


RTP Surveyors
12 Arwenack Street
Falmouth, Cornwall, TR11 3JD

T: 01326 318599
F: 01326 318179
E: falmouth@rtpsurveyors.co.uk
www.rtpsurveyors.co.uk


Office also at Bodmin

SCALE	DRAWN BY	CHECKED BY	DRAWING NO.	REV.	SIZE
1 to 100	TH	MM	10612-02	.	A3


This drawing is copyright. All materials and workmanship to comply with the current British Standards and codes of practice. Contractors to check ALL dimensions. Work from figured dimensions ONLY. Report ANY discrepancy to Architect or Surveyor before proceeding. IF IN ANY DOUBT ASK.

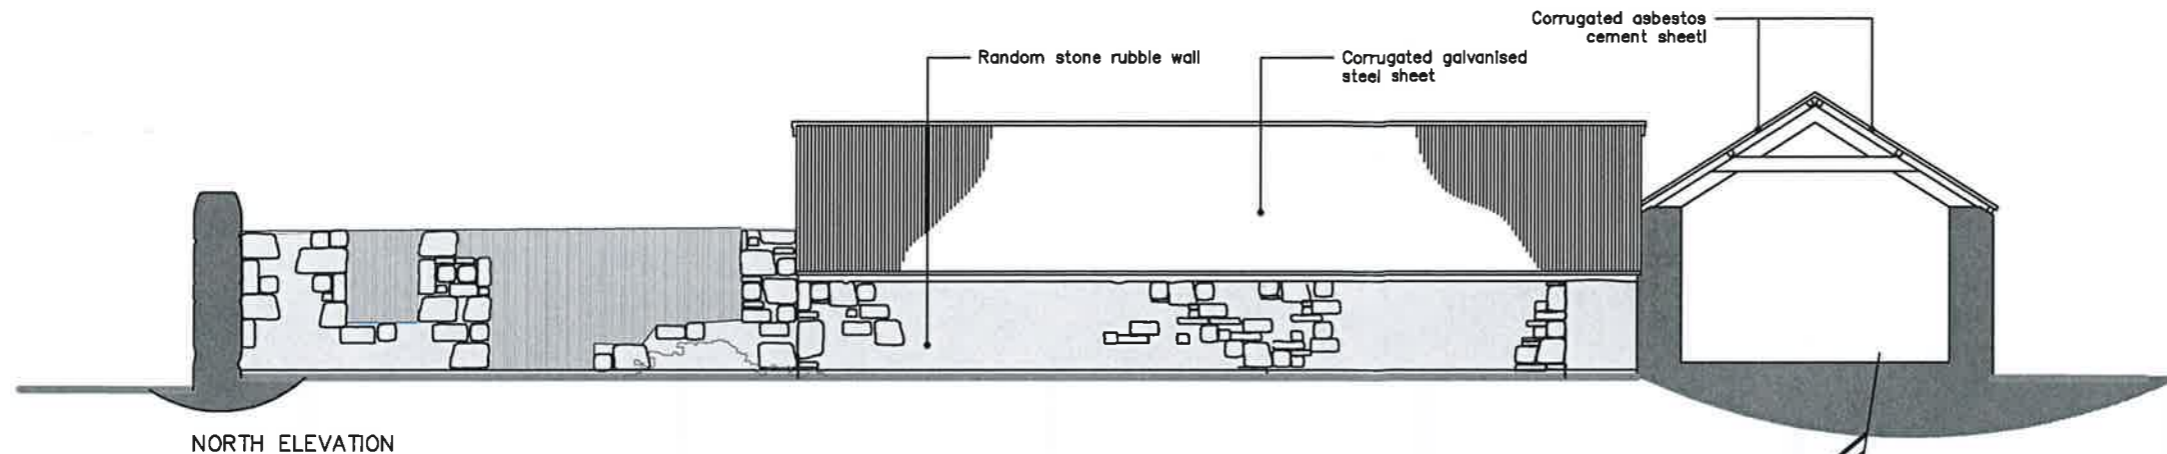


NORTH ELEVATION

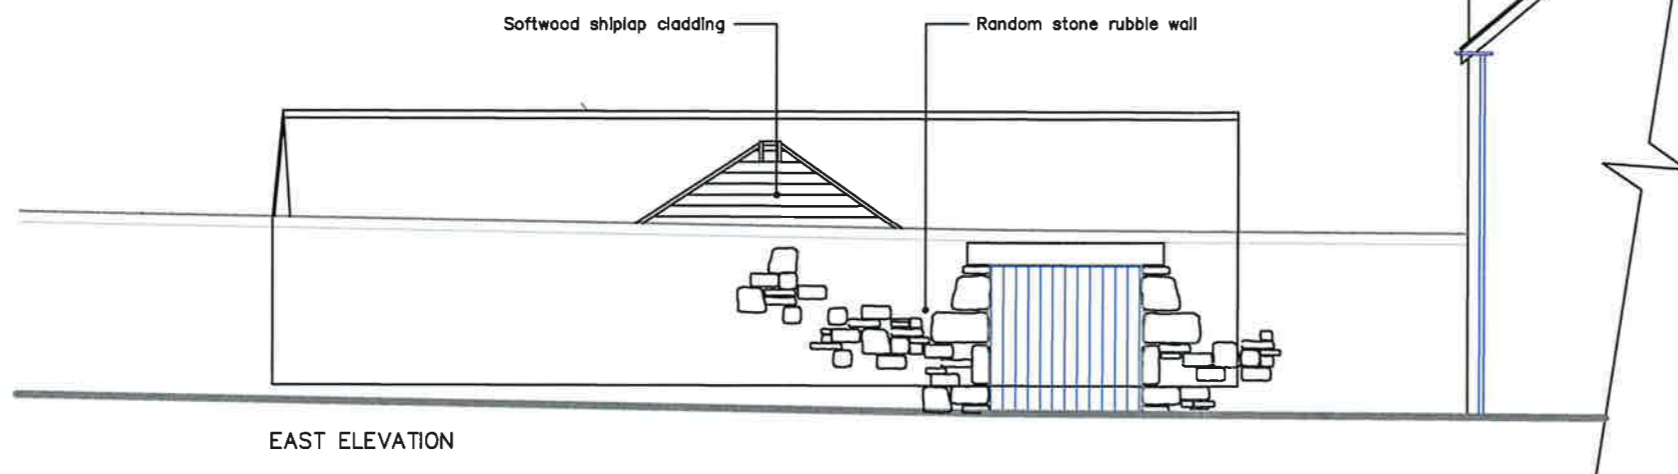

EAST ELEVATION

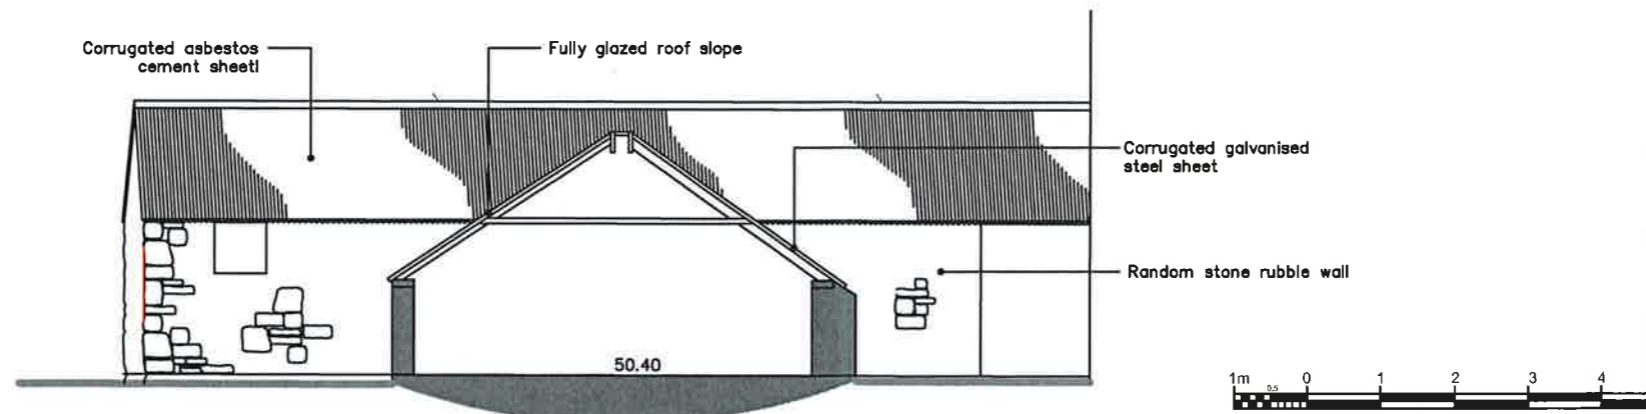

EAST SECTION/ ELEVATION

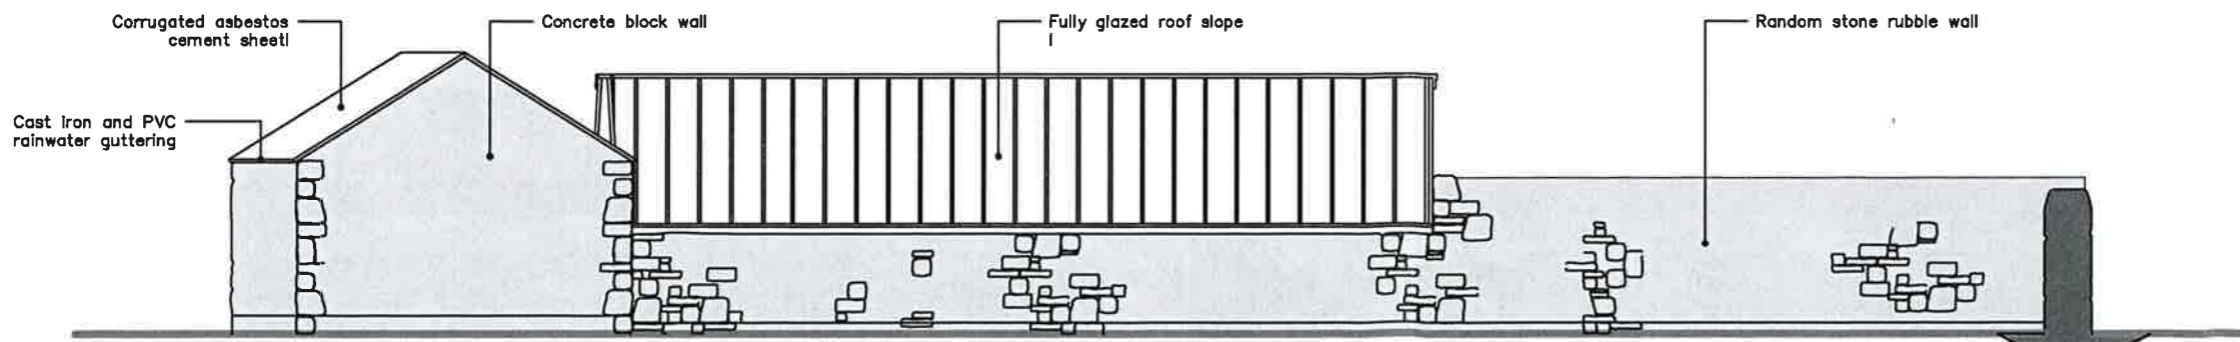

SOUTH ELEVATION

GENERAL NOTES

REVISION

REVISION	AMENDMENT	INITIAL	DATE

STATUS

- Preliminary
- Planning
- Building Regulations
- Tender
- Contract
- As Built

PROJECT

Historic Building Survey
Record Plan
Wellcross, Hugh Town
Isles of Scilly

CLIENT

Cornwall Rural Housing
Association

DRAWING TITLE

Elevations Survey

RTP
CHARTERED BUILDING SURVEYORS
 RTP Surveyors
 12 Arwensack Street
 Falmouth, Cornwall, TR11 3JD
 T: 01329 318599
 F: 01329 318179
 E: falmouth@rtpsurveyors.co.uk
 www.rtpsurveyors.co.uk
 Office also at Boscwin

SCALE	DRAWN BY	CHECKED BY	NO.	REV.	SIZE
1 to 100	TH	MM	10612-03	.	A3

This drawing is copyright. All materials and workmanship to comply with the current British Standards and codes of practice. Contractors to check ALL dimensions. Work from figured dimensions ONLY. Report ANY discrepancy to Architect or Surveyor before proceeding. IF IN ANY DOUBT ASK.